

Disclaimer: This drawing and design is subject to copyright and may not be reproduced without prior written consent. Contractor to verify all dimensions on site before commencing work. Report all discrepancies to the Spowers prior to construction. Figured dimensions take precedence over scaled dimensions.

Drawing Status

FOR CONSTRUCTION

Revisions

C0	17/05/22	ISSUE FOR CONSTRUCTION
C1	22/06/22	L2 Auto Door Locations
C2	01/08/22	Smoke Wall Detail
C3	17/08/22	L2 Dimensional Clarifications

Notes

NOTES - WALL SCHEDULE


01. PROVIDE IMPACT RESISTANT PLASTERBOARD FROM FLOOR LEVEL UP TO 1350mm. STANDARD PLASTERBOARD ABOVE. UNLESS NOTED OTHERWISE. REFER SPECIFICATION FOR EXCEPTIONS AND DETAIL.

02. THIS DRAWING PROVIDES GENERAL DESCRIPTION OF WALL TYPES AND MAKE-UP ONLY. REFER WALL SECTIONS FOR CONNECTION DETAILS AT FLOOR & CEILING LEVEL & TRIM


03. READ THIS DRAWING IN CONJUNCTION WITH THE ACOUSTIC REPORT

04. ALL PLASTERBOARD WALLS IN AMENITIES & BEHIND BASINS/SINKS TO BE EC08 IMPACT NR

LEVEL 2 LAYOUT SHOWN IS INDICATIVE FOR INFORMATION ONLY
REFER SPECIFICATION APPENDIX 6

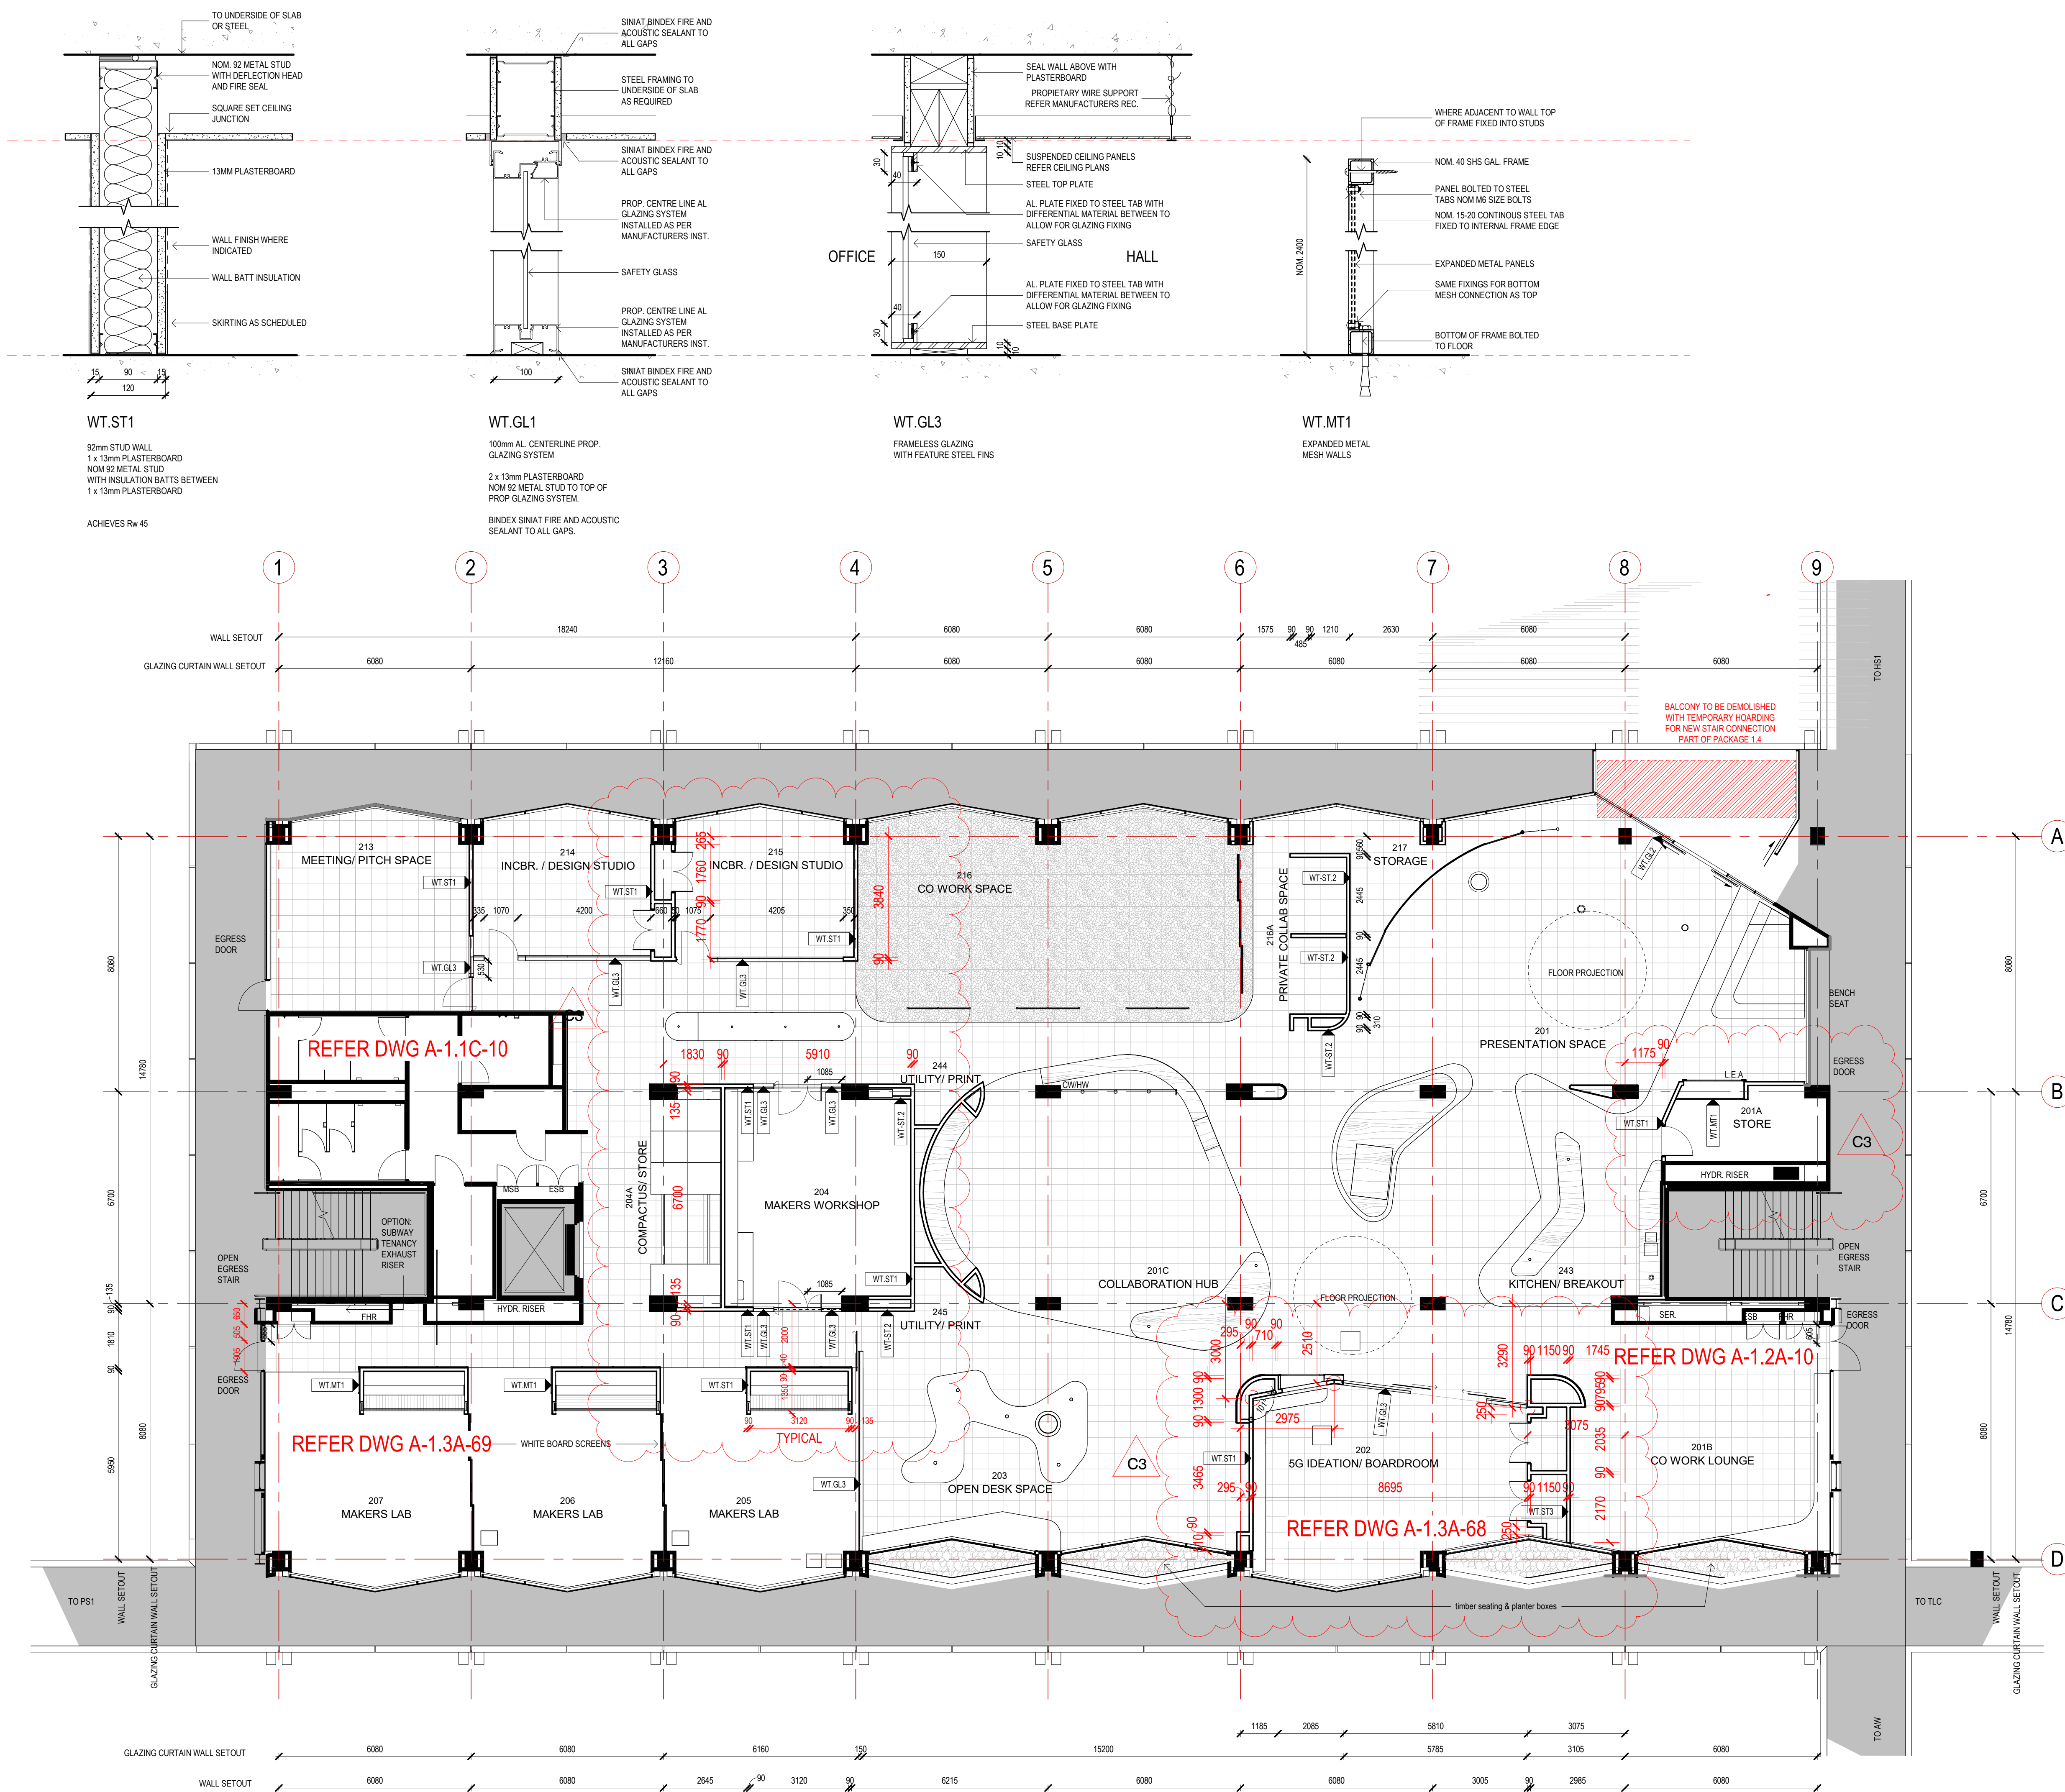

Godfrey Spowers (Victoria) Pty Ltd
1/460 Collins Street Melbourne Victoria Australia 3000
T +61 3 9514 6144 F +61 3 9529 6791
info@spowers.com.au spowers.com.au

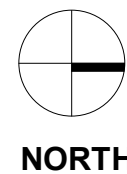

Client
LA TROBE UNIVERSITY

Project
THOMAS CHERRY UPGRADE WORKS

**PLENTY ROAD & KINGSBURY DRIVE
BUNDOORA VIC 3086**

Drawing
WALL SET OUT

Drawn	Checked	Approved
Author	Checker	Approver
Job Number	Date	Scale
2021007	19.08.22	As indicated
Drawing Number	Revision	
TC-2021-Arch-	A-1.3A-12	C3